
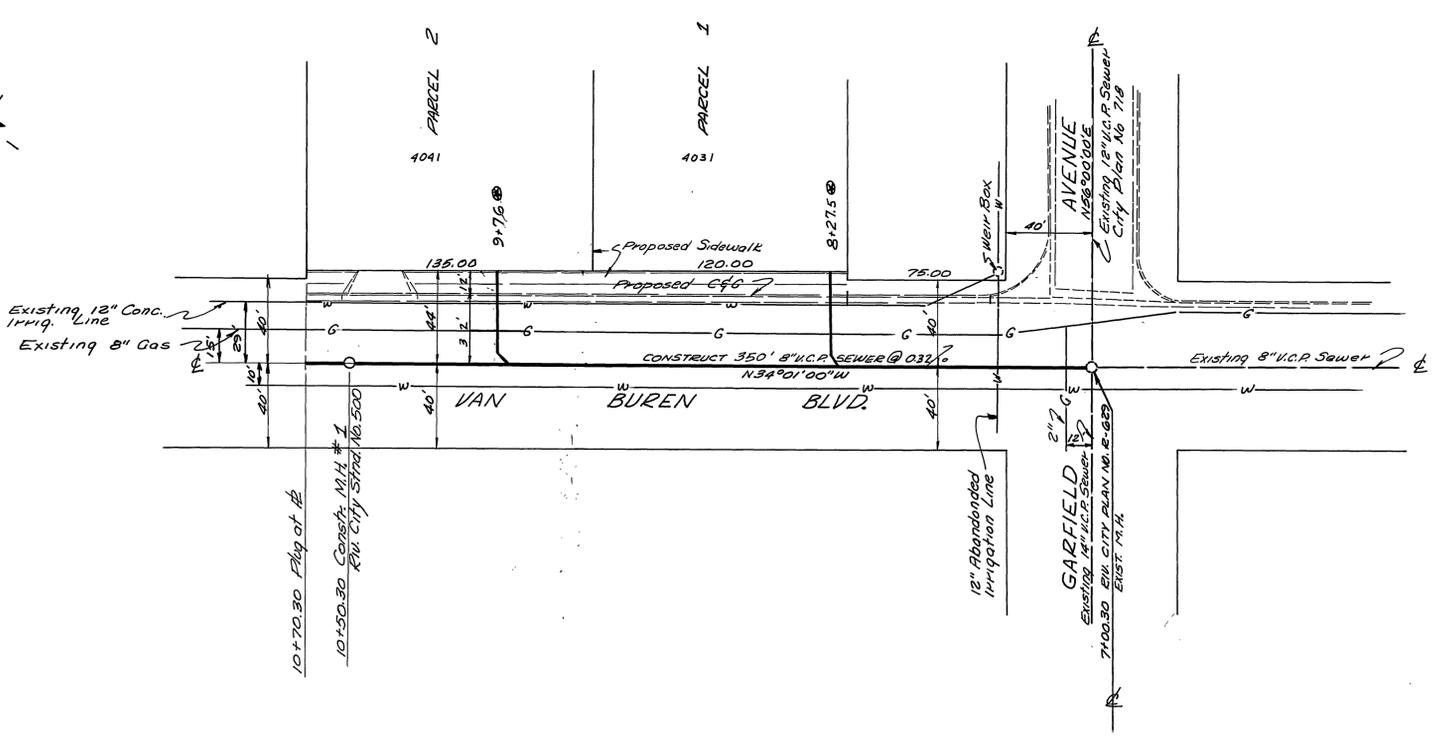


**BENCH MARK:** Pt. Nail in lead in center of Curb Return on S'ly Cor. VAN BUREN & GARFIELD. Elev. = 771.81

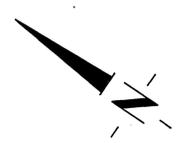

- GENERAL NOTES**
1. All pipes and laterals to be located in the field. All manholes to be Riverside City, Standard No. 500, unless otherwise noted on plan. Maximum vertical spacing of steps in all manholes shall be 32".
  2. All laterals to be "C" and extended to the property line, and shall be constructed in accordance with Standard Drawing No. 562.
  3. All construction shall be in accordance with Standards and Specifications No. 401 of the City of Riverside Department of Public Works. Pipes shall be bedded per Case II, Standard Drawing No. 422.
  4. It shall be the responsibility of the contractor to clear the Right of Way in accordance with the provisions of law as it affects each utility including irrigation lines and appurtenances, and at no extra cost to the City of Riverside.
  5. Joints in vitrified clay pipe sewers shall conform to A.S.T.M. Standard C-425-60T, or the latest revision thereof.

REVISIONS		
MARK	DATE	DESCRIPTION
*	8/11/64	Revised Grade Plan Per City Ord. 102

**J. F. DAVIDSON - CIVIL ENGINEER**  
 R.E. NO. 862  
 RIVERSIDE, CALIFORNIA  
 APPROVED BY: *J. F. Davidson* DATE: 4-6-64  
**CITY OF RIVERSIDE, CALIFORNIA**  
**DEPARTMENT OF PUBLIC WORKS**  
**SEWER PLAN & PROFILE**  
**VAN BUREN BLVD.**  
 2/5 799  
 1" = 40'      1" = 4'  
 HORIZ. SCALE      VERT. SCALE  
 DESIGNED BY:      CHECKED BY: G.S. WJG  
 DRAWN BY:      APPROVED BY: *J. F. Davidson* NO. 5-470  
 ASSISTANT CITY ENGINEER      DATE: 4-23-64      SHEET 1 1

As built 9/2/64 B.E.